


Ultra-sonic
Low pass filter potentiometer ?
~~Läsafflarna ok solljus?~~
Footprint for the coil
3V3_AVR LED on top layer!!!!
Level shift ultra sonic
Unfiltered button
~~Voltage levels of or-gate~~

| | | | | | |
|-------|--------------------------------------|--|---------------------------|----------|--|
| Title | | | EITF70 Lab: Top schematic | | |
| Size | Number | | | Revision | |
| A2 | | | | | |
| Date: | 2019-01-15 | | Sheet | of | |
| File: | C:\Work\A\ComputerReOrganization.Sch | | Drawn By: | | |

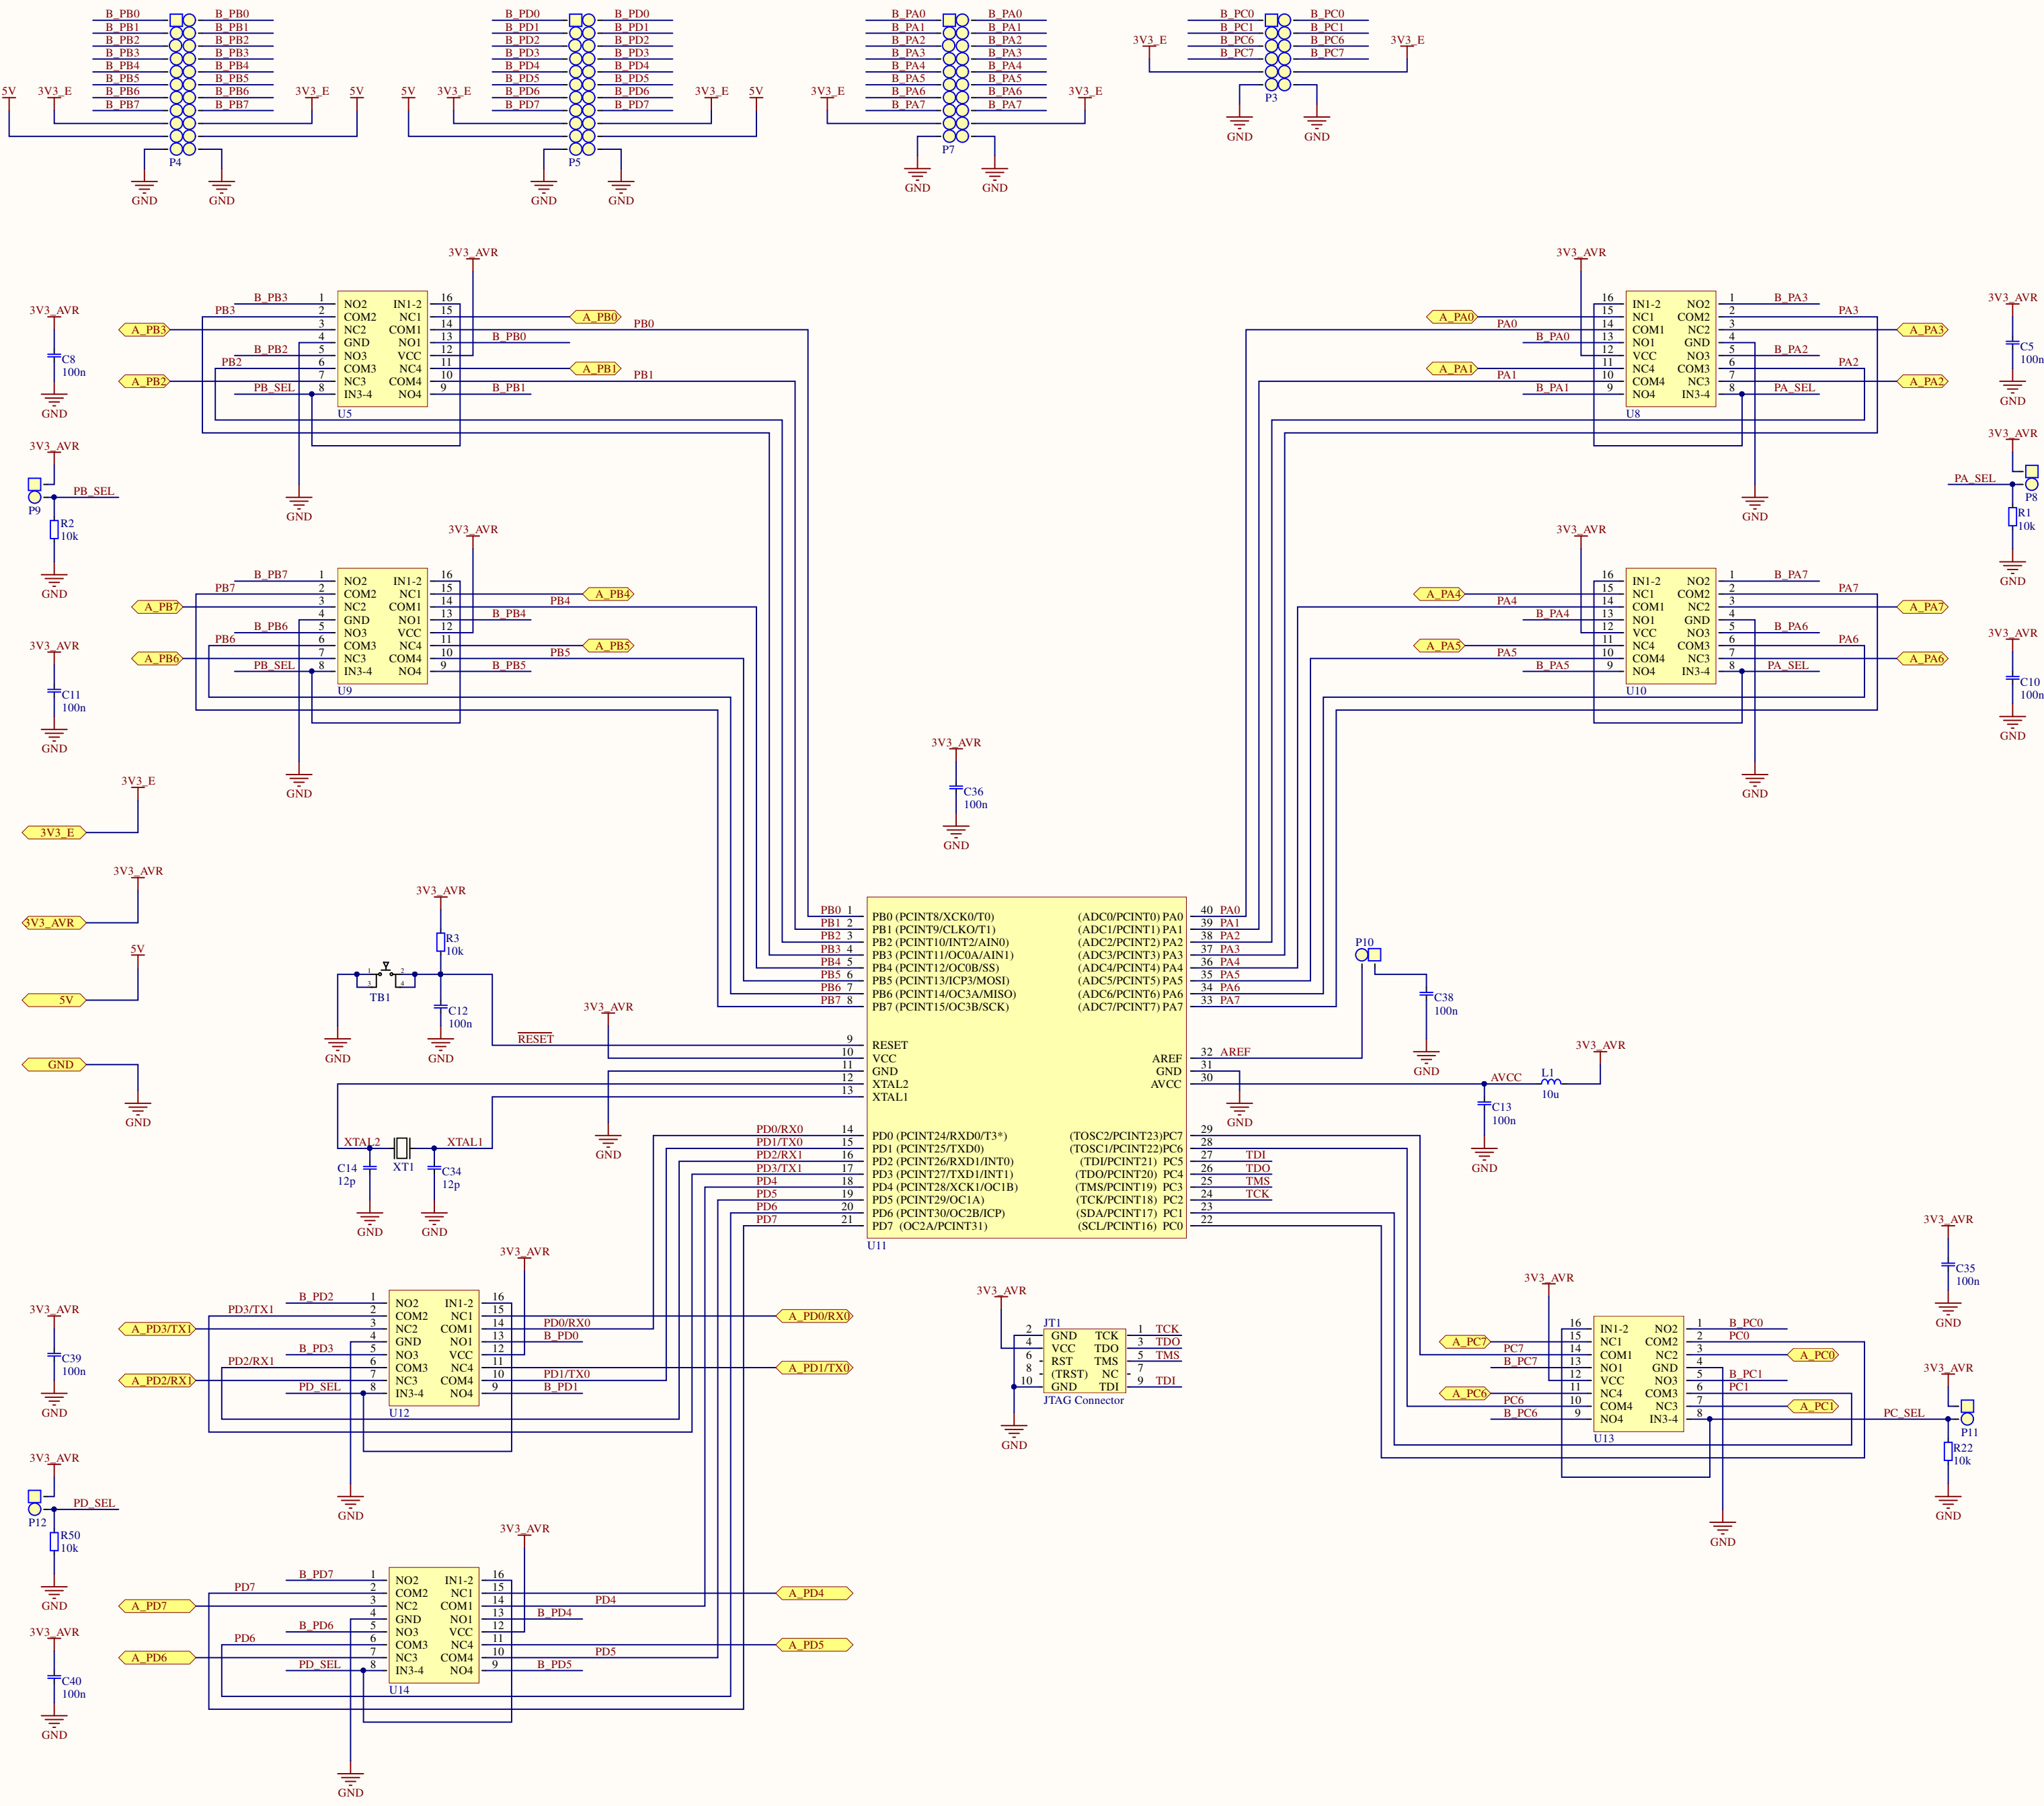

A

B

C

D

A

B

C

D

1

2

3


4

1


2

3

4

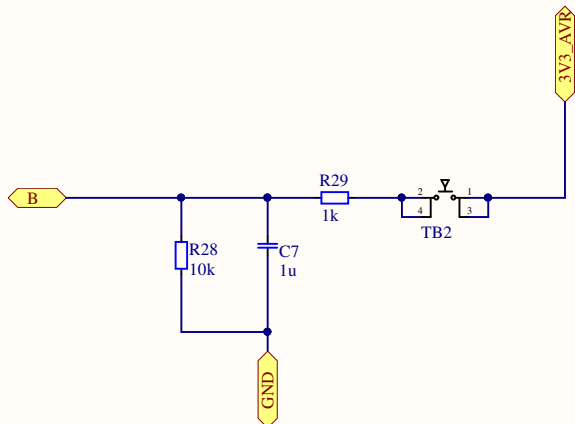


| | | | | | |
|-------|---------------------------|--|--------------------|-----------|----|
| Title | | | EITF70 Lab: Button | | |
| Size | Number | | | Revision | |
| A4 | | | | | |
| Date: | 2019-01-15 | | | Sheet | of |
| File: | C:\Work\...\Button.SchDoc | | | Drawn By: | |

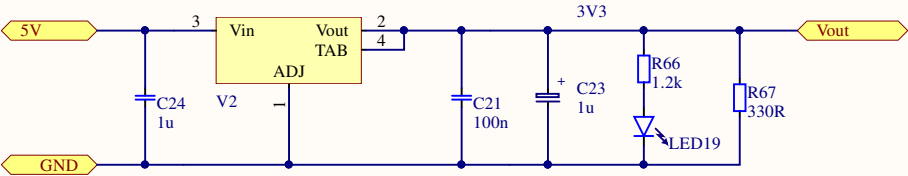

Lägga till en liten konding

| | | |
|-------------------------------|--------------------------|-----------|
| Title | | |
| EITF70 Lab: Voltage regulator | | |
| Size | Number | Revision |
| A4 | | |
| Date: | 2019-01-15 | Sheet of |
| File: | C:\Work\TLV1117LV.SchDoc | Drawn By: |

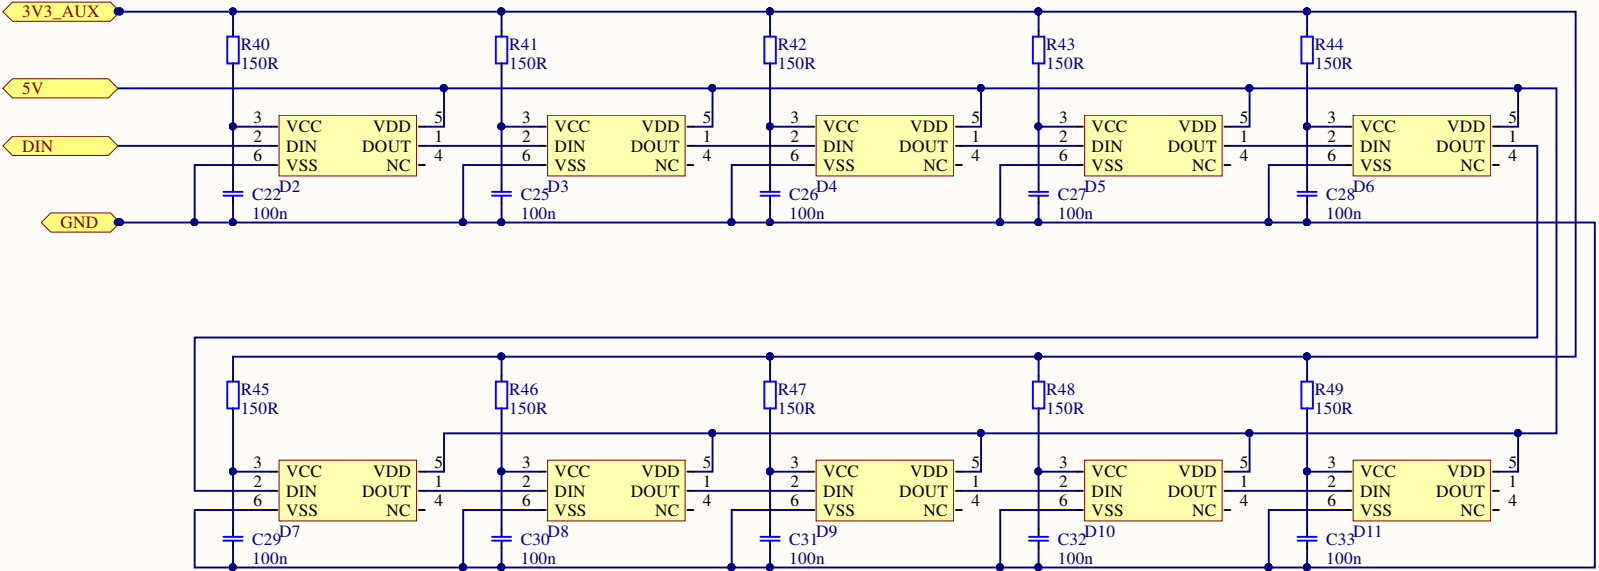

| | | |
|----------------------|-----------------------|-----------|
| Title | | |
| EITF70 Lab: Neopixel | | |
| Size | Number | Revision |
| A4 | | |
| Date: | 2019-01-15 | Sheet of |
| File: | C:\Work\WS2812.SchDoc | Drawn By: |